

Wastewater Applications Information for Plumbers and Drainers



Under the *Section 53L and 53MA Environment Protection Act 1970* "a person must not construct, install or alter a septic tank (wastewater) system unless the person holds a permit..."and "...must comply with a permit and any conditions to which it is subject."

As the plumber or drainer for an onsite wastewater treatment and disposal system these responsibilities lie with you, whether or not you have submitted the application to install a wastewater system.

What do I need to know before starting work?

1. Before starting work you need to ensure that you have a copy of the permit to install/alter the wastewater system and the approved plan. Remember that alterations require a permit even if it is just the drain leading to the septic tank.
2. Read all the conditions on the permit and make sure the approved plan is the same as your intended installation. Contact the authorised officer that signed the permit to install for further information or if anything needs changing before starting work.
3. Please note: If the approved plan or system design is to be changed significantly, an application to alter the permit will be required.

What inspections are required of the wastewater system?

Inspections are required on all wastewater installations and alterations. If you are not the applicant, make sure it is clear with your employer whether you are expected to contact Council to organise the inspections. If the applicant will be organising inspections, make sure they are given more than 48 hours notice so that they can submit the requests for inspections.

Inspection Requirements

- a. At least 48 hours notice is to be given for inspections of works being carried out
- b. When tanks installed and trenches dug and material installed prior to backfilling
- c. When all works are completed.



Northern Grampians Shire Council
LIVE | WORK | INVEST | VISIT

CONTACT US

- ngshire@ngshire.vic.gov.au
- www.ngshire.vic.gov.au
- (03) 5358 8700
- PO Box 580 Stawell VIC 3380

CONNECT WITH US

- facebook.com/ngshire
- [@ngshire](https://twitter.com/ngshire)
- [@northerngrampiansshire](https://www.instagram.com/northerngrampiansshire)
- #ngshire #liveworkinvestvisit #wandervictoria

Wastewater Applications - Information for Plumbers and Drainers

Inspections can be organised by contacting Council's Environmental Health Department by email (health@ngshire.vic.gov.au) or by calling (03) 5358 8700. Please include your name, phone number, address of the proposed installation or permit number and the date and time you want the inspection. An officer will get back to you to confirm the inspection.

The work must not be backfilled until the inspection has been completed or has been specifically approved by the authorised officer.

Getting the Approval to Use a Wastewater System

To get an approval to use a wastewater system the following items are required. You will also need to provide the paperwork to your employer. If you are the applicant or responsible for obtaining the approval to use, send a copy to Council as well (email: health@ngshire.vic.gov.au).

1. The completed system must be inspected and approved by the authorised officer. Another final inspection may be required if the trenches are installed before the rest of the sanitary drains or treatment unit/septic tank.
2. An accurate as laid drainage plan must be submitted. The plan must show all below ground drains, trenches and irrigation lines. All inspection openings are to be included with accurate measurements of all drains and locations of distribution pits, trenches and valve boxes for irrigation. (see attached examples).
3. Copy of VBA Plumbers Compliance Certificates for all sanitary drains as well as wastewater disposal system. For some alterations you may find that a compliance certificate is required for less than \$750 work. If this condition is on the permit, the compliance certificate will be required.
4. Copy of Commissioning Certificate for any aerated treatment unit installed.

Questions?

Enquiries regarding the installation or alterations to septic tank systems or wastewater treatment systems should be directed to the Environmental Health Officer on (03) 5358 8700 or email (health@ngshire.vic.gov.au).



Northern Grampians Shire Council
LIVE | WORK | INVEST | VISIT

CONTACT US

-  ngshire@ngshire.vic.gov.au
-  www.ngshire.vic.gov.au
-  (03) 5358 8700
-  PO Box 580 Stawell VIC 3380


CONNECT WITH US

-  facebook.com/ngshire
-  [@ngshire](https://twitter.com/ngshire)
-  [@northerngrampiansshire](https://www.instagram.com/northerngrampiansshire)
-  #ngshire #liveworkinvestvisit #wandervictoria


Wastewater Applications - Information for Plumbers and Drainers

Examples of As Laid Drainage Plans

UNDER FLOOR SEWER

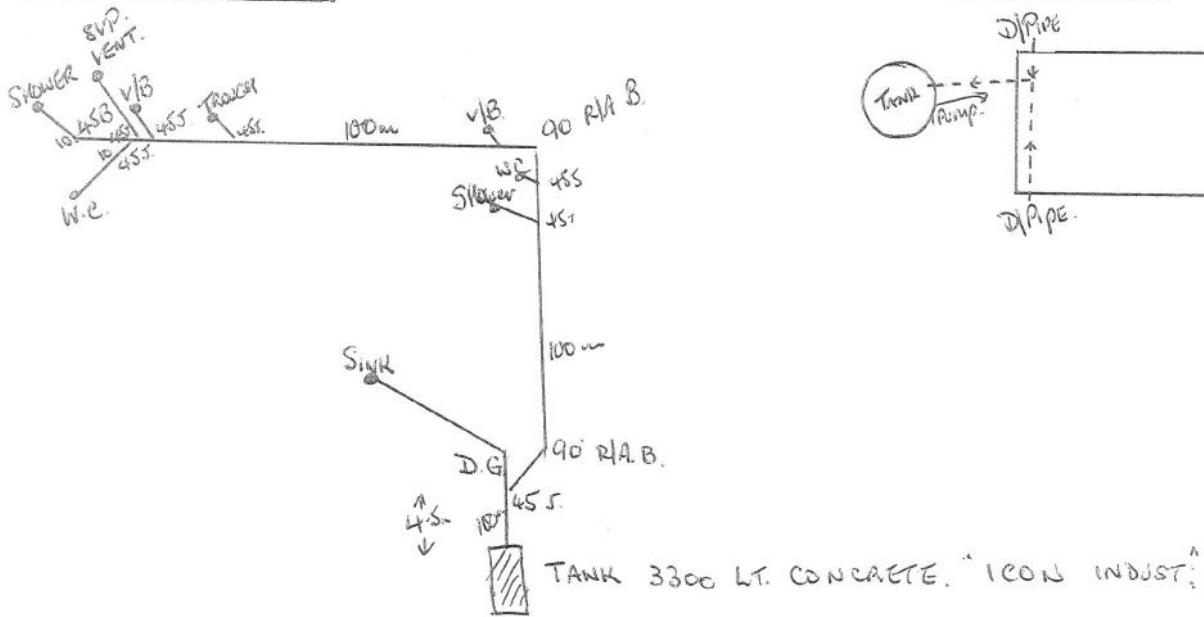

STORM WATER

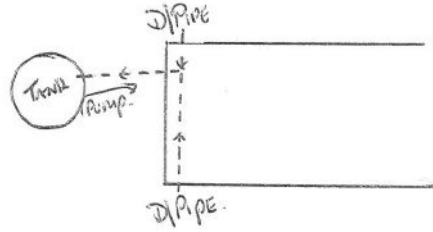


SEPTIC PLAN

COMPLIANCE NO. _____

Lic. PLUMBER
Tel. (03)
Lic. No.
ABN
c/o

CLIENT.

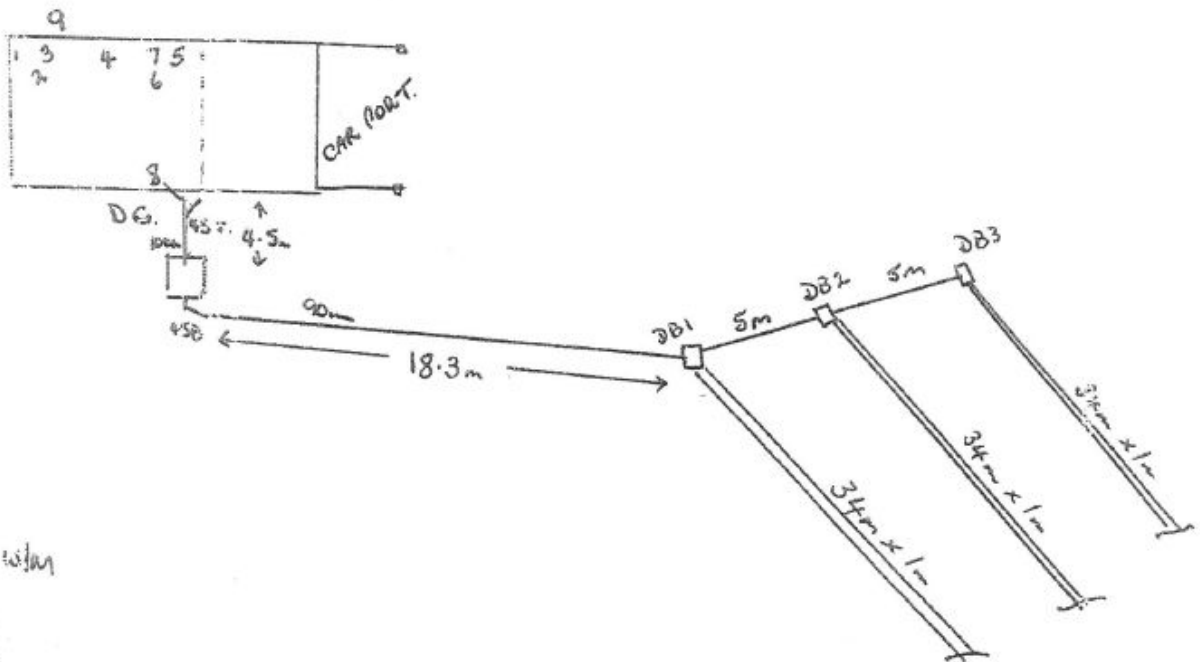

- 1= SHOWER
- 2= WC.
- 3= VIBRATED
- 4= TRAP WITH W/M
- 5= WC
- 6= SHOWER
- 7= VIBRATED
- 8= SINK
- 9= SUP.